



Building Guide – Installing a Septic System

Phone: 705-728-4784 EXT 2017 Email: <u>building@springwater.ca</u> Email: <u>zoning@springwater.ca</u>

Last Updated: February 7th 2024

705-728-4784 EXT 2017

BUILDING SERVICES

BUILDING@SPRINGWATER.CA

General Information:

(?)

Do I need a permit?

Approval in writing is required from the Township of Springwater for the following septic projects:

- Installation of a private sewage system (new or replacement)
- Repairs / modifications / upgrades to an existing sewage system
- Any work that may affect an existing sewage system
- Any works that may require a sewage system

If you are installing a level II, level III, or level IV Treatment Unit septic system, a renewable maintenance contract is required for all treatment unit systems.

Septic systems must be installed by the owner or an installer who is currently licensed by the Ministry of Municipal Affairs and Housing

Online Submissions:

All permit applications are to be submitted online via our <u>Web Portal</u>. Before you begin, please ensure that all required documents are complete and signed (as applicable). Scan each document separately and give it a recognizable file name and save it to your computer.



For further assistance please see our **Digital Permit Submission Guide.**

Permit Issuance:



Once the permit has been completely reviewed by all internal and external agencies the applicant will be contacted via email and informed of any action required for the permit to be issued. **Permit fees are payable upon issuance.**

Building permit fees are determined by an established cost per square foot, and/or by established flat fees as detailed in the Township of Springwater

Fees and Charges By-law.

Scheduling Inspections:

After the permit has been issued it is the responsibility of the applicant to schedule inspections throughout the completion of the work. The required inspection(s) will be outlined on the permit card provided at the time of issuance.



In order to pass a final inspection, a copy of the as built drawings is required. This documents should be emailed to building@springwater.ca. If we have not received the drawing before the inspection is to take place and have not been advised that it would not be available on site, the inspection may be cancelled. Please refer to sample as built drawings at the end of this guide.

Please note although every attempt has been made to provide accurate information throughout this guide, it is subject to change without notice and is provided **as a guide only**. It is not intended to be used instead of the current Municipal By-laws or the current Building Code.


Pormit Submission Chackliste

Permit Submission Checklist:
1. Completed Septic Permit Application:
Application for a Permit to Construct or Demolish & Schedule(s) - Septic
Schedule 1: Designer information
Schedule 2: Sewage system installer information
Schedule 2A: Sewage system information
Schedule 2C: Class 4 sewage system calculations
2. Required Supporting Documents:
 Site Plan; showing the proposed installation location including all dimensions in relation to the proposed septic, e.g., from the septic system to property lines and existing and proposed structures on the property. Please include any future projects such as a garage, storage building, deck, pool or hot tub. Confirmation that two test holes to a depth of 3 ft below the proposed elevation of the stone layer, of an adequate size to review the soil conditions, within the proposed leaching bed area are ready to be inspected. For a fully inground system test holes of 3 ft wide by 6 ft deep with sloped or stepped on one side should be
provided. Test holes shall be protected and marked for visibility until after they have been inspected. Once inspected by Township Staff, test holes should be backfilled. This inspection is required prior to the issuance of a permit unless T-time analysis is provided.
Opy of deed (or proof of ownership if property has been recently transferred)
Letter of Authorization (if someone other than the homeowner)
 Applicable law approval, please check using the following links to determine if they apply to your property: Conservation Authority Approval, Ministry of Transportation Approval, County Of Simcoe Approval

705-728-4784 EXT 2017 BUILDING SERVICES

BUILDING@SPRINGWATER.CA

Township of Springwater – SAMPLE SITE PLAN

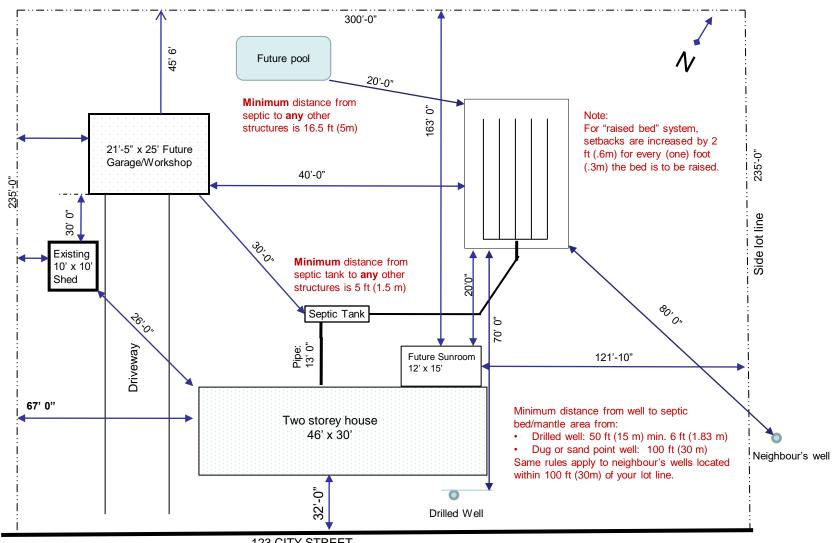

123 CITY STREET

Designer name Designer address Designer contact information

Page 1 of 1


Project: SEPTIC REPLACEMENT

Designer: Name & BCIN Firm BCIN: Company Name and BCIN

Date Designed: March 8, XXXX Scale: NOT TO SCALE

Township of Springwater - SAMPLE 1 -

SEPTIC AS-CONSTRUCTED DRAWING

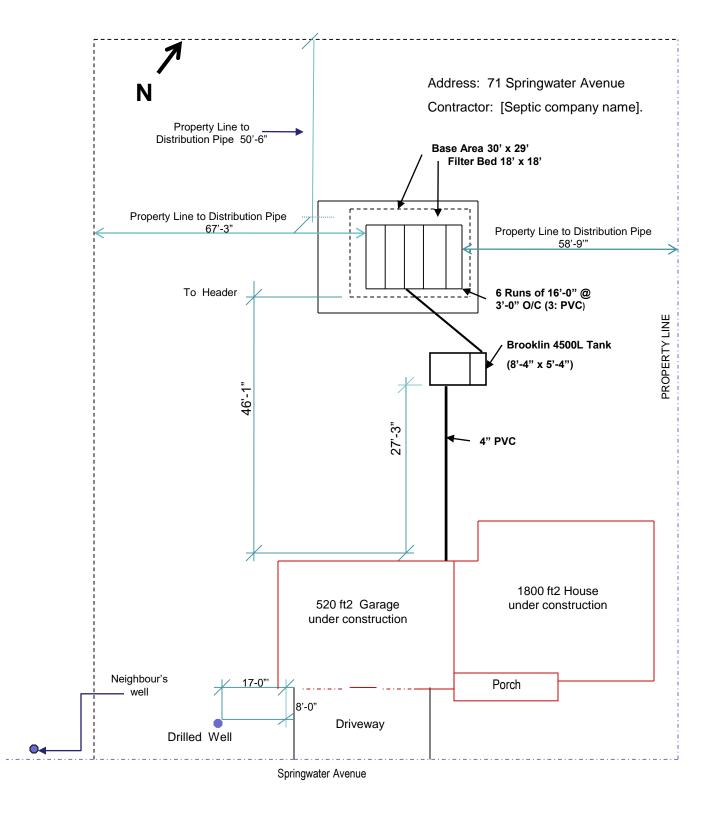

Township of Springwater - SAMPLE 2 -

